


7,150 SF Office/
Warehouse Building
For Sale

3324 Towerwood Drive

Farmers Branch, Texas 75234

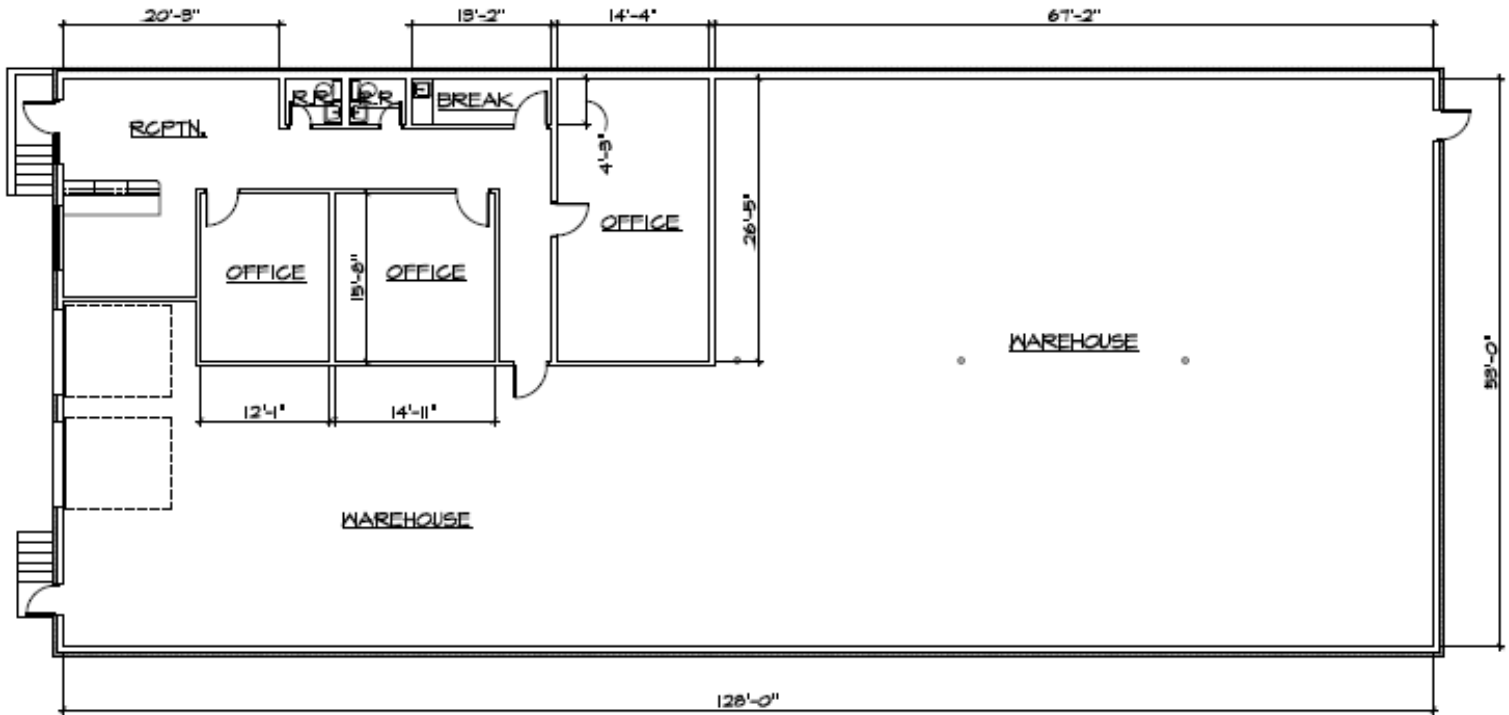

SHEET	DATE
A1	12/16/16
1 OF 1 SHEETS	SCALE
	1/16" = 1'-0"
	PROJECT NO.
	16144

AN AS BUILT FOR:
3324 TOWERWOOD DRIVE
 FARMERS BRANCH, TX 75234 **7,150 SF**

FOR MORE
INFORMATION
CONTACT:
 RICH YOUNG, JR.
 RICH YOUNG
COMPANY
 (972) 236-7645

Simon
 Design Services
 932.880.6636
 kyle@simonnde@services.com



THE INFORMATION CONTAINED HEREIN HAS BEEN GIVEN TO US BY THE OWNER OF THE PROPERTY OR OTHER SOURCES WE DEEM RELIABLE. WE HAVE NO REASON TO DOUBT ITS ACCURACY, BUT WE DO NOT GUARANTEE IT. ALL INFORMATION SHOULD BE VERIFIED PRIOR TO PURCHASE OR LEASE.