


Floor Plan  
Suite 244

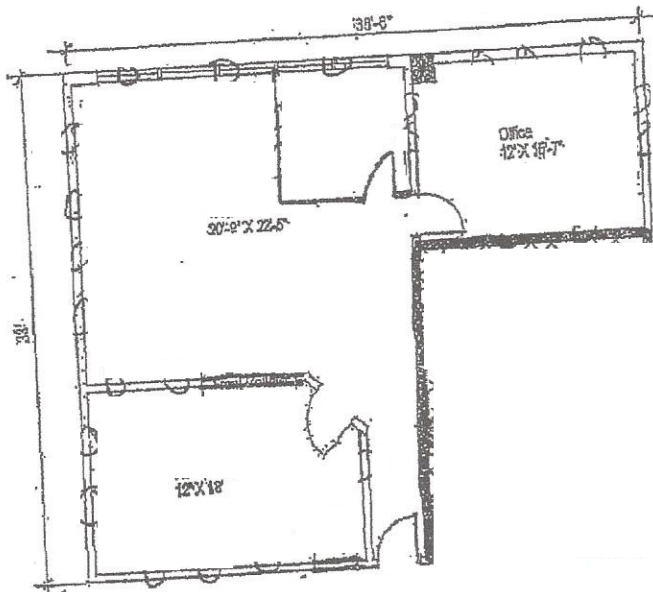

Floor Plan  
Suite 244  
3740 N. Josey  
Carrollton, Texas